Friday, 17/10/2008 12:43:48 PM

User

Julie Dawson

#### **Process Sheet**

Customer

: CU-DAR001 Dart Helicopters Services

Job Number : 42721B

**Estimate Number** 

: 10193

P.O. Number

This Issue

: 17/10/2008

: NC

First Issue **Previous Run** 

: 41624A

: //

Type

S.O. No. :

: LARGE FAB ASSY

Part Number

**Drawing Name** 

: D2512

: 350/212/130 BASKET LID

**Drawing Number Project Number** 

: D2512 REVE : N/A

**Drawing Revision** 

Material **Due Date** 

: 05/11/2008

Qty:

1 Um:

Each

**Checked & Approved By** 

Comment

Written By

Prsht Rev.

: Rev Est:M 03.01.31

Added D2012-117 for D130-701-041 KJ/

RF

Est Rev:N 06.04.05

Added level21

Est Rev:O 08-08-29 Est Rev:P 08-09-24

revE as per dwg DD verified by:EC plug holes prior to powder coating DD

verified by:EC

**Additional Product** 

Job Number:



Seq. #:

**Machine Or Operation:** 

Description:

1.0

M304TS0750W065

304 SQ Tube .75x.75x.065W

Total: 45.7594 f(s)/Unit

45.7594 f(s)

Comment: Qty.:

3/4"x3/4" 304/316 SS tube .065" wall

Batch: *M/100//* 

Basket Hoop

2.0

D31663

Comment: Qty.:

1.0000 Each(s)/Unit Total: 1.0000 Each(s)

Pick:

**Qty Part Number** 

Description

Batch

1 D3166-3

**Basket Hoop** 

<u>1342</u>717

3.0

D2506

Label Plate



Comment: Qty.:

1.0000 Each(s)/Unit

Total:

1.0000 Each(s)

Pick:

Description

**Qty Part Number** 1 D2506

Label Plate

Dart Aerospace Ltd
--------------------

W/O:				WORK ORDER	CHANGES	*	•	, ,	S. S	22.
DATE	STEP		PR	OCEDURE CHANGE	· .	Ву	Date	Qty	Approval Chief Eng / Prod Mgr	Approval QC Inspector
						:				
			· · · · · · · · · · · · · · · · · · ·					•	***	
,	i					!	J			
Part No	•		PAR #:	Fault Category:	NC	R: Yes	No <b>DQ</b>	<b>A</b> :	_ Date: _	
	1	Resolution:	ř	Disposition:	QA	: N/C C	losed:		Date:	

NCR:		WORK ORDER NON-CONFORMANCE (NCR)										
		Description of NC		Corrective Action Section B		Verification	Approval	Annroval				
DATE	STEP	Section A	Initial Chief Eng	Action Description Chief Eng	Sign & Date	Section C	Approval Chief Eng	Approval QC Inspector				
		· · · · · · · · · · · · · · · · · · ·	·									
	:			<b>X</b>		• .	•					
	-	<del></del>		· ************************************			•					
		,				~ · //						
		,			:	•	# ¥.;					
						<i></i> -		"				
						. <b>.</b>		•				
						·						
			,									
	1		1		1							

Friday, 17/10/2008 12:43:48 PM Date: Julie Dawson User: **Process Sheet** Drawing Name: 350/212/130 BASKET LID Customer: CU-DAR001 Dart Helicopters Services Job Number: 42721B Part Number: D2512 Job Number: Seq. #: **Machine Or Operation:** Description: 4.0 D23271 Spacer Bushing Comment: Qty.: 2.0000 Each(s)/Unit Total: 2.0000 Each(s) Pick: **Qty Part Number** Description Batch 840390 2 D2327-1 Bushing 5.0 D22321 Basket Hinge Comment: Qty.: -2.0000 Each(s) 2.0000 Each(s)/Unit Total: Pick: Batch **Qty Part Number** Description B39459 2 D2232-1 Hinge plate 6.0 D2581 Mounting Bracket Comment: Qty.: 2.0000 Each(s)/Unit Total: 2.0000 Each(s) **Qty Part Number** Description Batch 2 D2581 Mounting Bracket M304EX07516F 7.0 Comment: Qty.: 18.0000 sf(s)/Unit Total: 18.0000 sf(s) Pick: m 109 383 (2) **Qty Part Number** Description Batch M107510 (16 M304EX0.75-16F Expanded Metal LARGE FABRICATION RESOURCE 1 8.0 LARGE FAB Comment: LARGE FABRICATION RESOURCE 1 1-Cut 3/4" x 3/4" square tubing as per Dwg D2512 2-Cut (4) D2236 From D3166-3 3-Drill holes in D2512-1 as per Dwg D2512 using Drill Jig DT8305 5-Weld as per Dwg D2512 using Welding Table and corner Jig Deburr as required

## **Dart Aerospace Ltd**

W/O:		WORK ORDER CHANGES								
DATE	STEP	PROCEDURE CHANGE	Ву	Date	Qty	Approval Chief Eng / Prod Mgr	Approval QC Inspector			
	-									
Part No	:	PAR #: Fault Category: No	CR: Yes	No DQ	<b>A:</b>	Date:				

NCR:		\	WORK ORDER NON-CONFORMANCE (NCR)									
		Description of NC	-	Corrective Action Section B		Verification		Approval				
DATE STE		Section A	Initial Chief Eng	Initial   Action Description   Sign &		Section C	Approval Chief Eng	Approval QC Inspector				
					,	<u> </u>		h   				
								·				
							,					
							<del>-</del>					

	riday, 17/10/2008 12:43:48 PM	· ·	
. User: Ju	ulie Dawson	<b>Process Sheet</b>	
Custome	er: CU-DAR001 Dart Helicopters Services	Drawing Name: 350/2	12/130 BASKET LID
Job Numbe	A2721R	Part Number: D251	າ .
Job Number:	13000 0000 0000 0000 0000 0000	Fait Nullinet, D201	2
Seq. #:	Machine Or Operation:	Description	on:
9.0	QC9	VISUAL WELDING INSPECTION	1101110 10110 10110 1011(100)
Comr	ment: VISUAL WELDING INSPECTION		Mosley 107
10.0	QC6	DIMENSIONAL CHECK	
		18.2	
	ment: DIMENSIONAL CHECK		S 07/01/07 FO
11.0	POWDER COATING	POWDER COATING	110011111111111111111111111111111111111
		m/09996	
Comr	ment: POWDER COATING		
	1- Plug holes in D2581 and in D2	2327-1 bushing prior to powder coating	
	2- Powder Coat White Gloss (Re	ef: 4.3.5.1) as per QSI 005 4.3	
	1ST COAT:	^ <del>-</del>	
	START TIME:	<u>95</u>	
	OVEN TEMPERATURE: 40	<u> </u>	
	FIINION HIVIE.	<u> </u>	
	2ND COAT:		
	START TIME:		El 29/01/07
,	OVEN TEMPERATURE: FINISH TIME:	<u> </u>	FL 09/01/07
12.0	HAND FINISHING1	HAND FINISHING RESOURCE #1	
,		10 0 0 in	
		m/09917	
Comm	ment: HAND FINISHING RESOURCE	#1 ck as per Dwg D2512 and QSI 005 4.4	Batch: F. 29/01/07
13.0	QC3	INSPECT POWDER COAT/CHEMICA	
Comr	ment: INSPECT POWDER COAT/CHE	MICAL CONVERSION	2 02/61/08 (tc
14.0	PACKAGING 1	PACKAGING RESOURCE #1	
		-	
Comr	ment: PACKAGING RESOURCE #1		
	Identify and Stock	al glile	54
· ·			

Form: rprocess

Page 3

## **Dart Aerospace Ltd**

W/O:		WORK ORDER O	CHANGES				
DATE	STEP	PROCEDURE CHANGE	Ву	Date	Qty	Approval Chief Eng / Prod Mgr	Approval QC Inspector
			·			٠	
			:				
							·
Part No	:	PAR #: Fault Category:	NCR: Yes	No <b>DQ</b>	<b>A</b> :	_ Date: _	

Resolution:		esolution:	Disposition: QA: N/C Closed: Date:						
		1	WORK ORDER NON-CONFORMANCE (NCR)						
DATE STEP	Description of NC	Corrective Action Section		В	Verification		A1		
	STEP	Section A	Initial Chief Eng	Action Description  Chief Eng	Sign & Date	Section C	Approval Chief Eng	Approval QC Inspector	
						:			
· · ·									
		·							
							·		
	i		i			1	1	1	

Date: User: Friday, 17/10/2008 12:43:48 PM

Julie Dawson

**Process Sheet** 

Customer: CU-DAR001 Dart Helicopters Services

Drawing Name: 350/212/130 BASKET LID

Job Number: 42721B

Part Number: D2512

Job Number:



Seq. #:

**Machine Or Operation:** 

Description:

15.0

QC21

FINAL INSPECTION/W/O RELEASE

Comment: FINAL IN


ION/W/O RELEASE

Job Completion




### **Dart Aerospace Ltd**


Dait Ac	ospace	Liu							
W/O:			W	ORK ORDER CHANGE	S				
DATE	STEP	PRO	OCEDURE CHA	NGE	Ву	Date	Qty	Approval Chief Eng / Prod Mgr	Approval QC Inspector
							ŀ	!	
Part No	:	PAR #:	Fault Cate	gory:	NCR: Yes	No <b>DQA</b>	:	_ Date: _	
	Re	esolution:	: Disposition:			QA: N/C Closed:			
NCR:			WORK ORD	ER NON-CONFORMA	NCE (NCF	R)			
		Description of NC		Corrective Action Section		Verifica	ation	Approval	Approval
DATE	STEP	Section A	initial Chief Eng	Action Description Chief Eng	Sign 8 Date	Sectio		Chief Eng	QC Inspector
	1 1		1		ŀ	- 1			

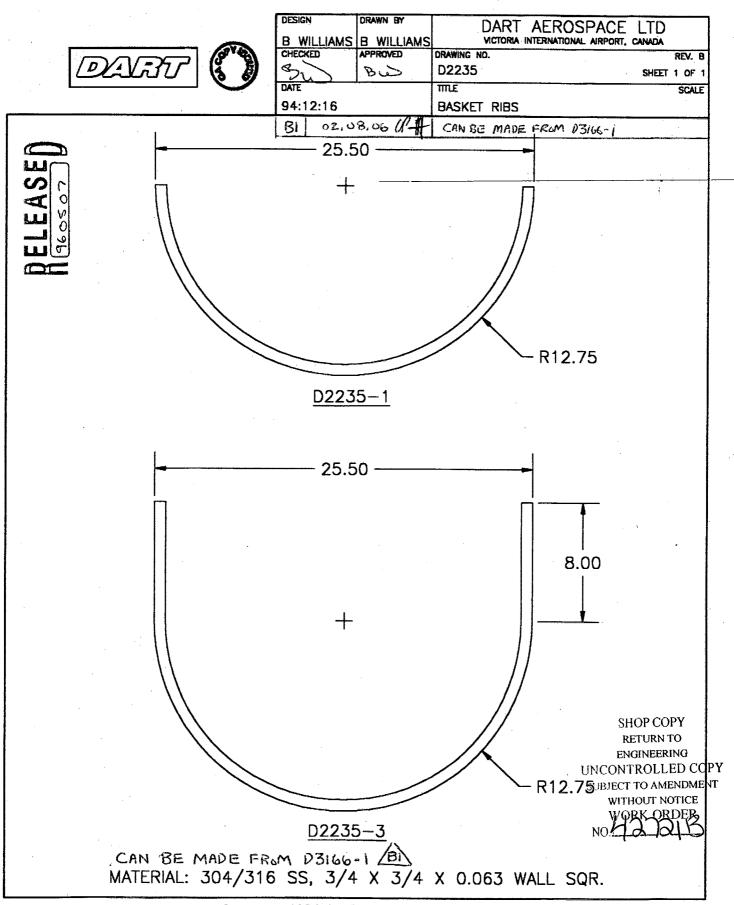



# PARTS LIST FOR D2512 BASKET LID ASSEMBLY

PART NO	QUANTITY	LENGTH A	LENGTH B	DESCRIPTION
D2512-1	2		25.50	RIB
D2512-3	2		95.30	RIB
D2512-5	6	30.84		RIB
D2512-7	3	30.63		RIB
D2232-1	2	N/A	N/A	HINGE PLATE
D2236	4	N/A	N/A	RIB
D2327-1	2	N/A	N/A	BUSHING
D2506	1	N/A	N/A	LABEL PLATE
D2581	2	N/A	N/A	MOUNTING BRACKET

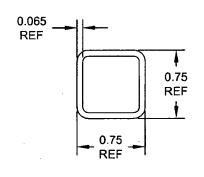

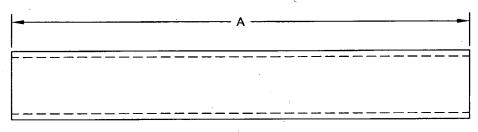

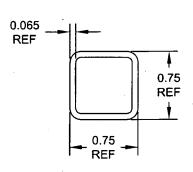

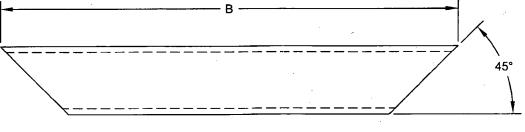



#### D2512-1/-3/-5/-7 NOTES:

- 1) MATERIAL: AISI 304/316 SS, 3/4 X 3/4 X 0.065 WALL SQUARE TUBING REF. DART SPEC M304TS0.750W.065
- 3) TOLERANCES: PER DART QSI 018 UNLESS OTHERWISE NOTED
- 4) UNITS: INCHES UNLESS OTHERWISE NOTED
- 5) BREAK SHARP EDGES: 0.005 TO 0.010 MAX
- 6) IDENTIFICATION: NONE
- 7) WEIGHT: N/A
- 8) CUT LENGTH/SHAPE PER DIAGRAM AND PARTS LIST

		7 (1)	1
<u> </u>	В —		
<del></del>			7´ \ 45°

INCORPORATED D1 & D2. MATERIAL FOR -1, -3, -5, & -7 WAS 0.060 WALL. SHT 3 ZN C4 TOLERANCE REMOVED FROM 95.30 DIM. DRAWING TRANSFERED TO "B" AJS 08.06.17 FORMAT AND UPADTED TO CURRENT STANDARDS. SHT 3 VIEWS INVERTED FOR CLARITY. SHT 2 MESH MATERIAL CALLOUT UPDATED. CHANGE HINGE CP 01.04.19 REMOVE DOUBLE SKIN SECTION, 99.07.06 ADDED MEMBERS, INCORP DEO 9074 ADDED LATCH CHANNEL & LABEL PLATE BW 96.05.24 NEW ISSUE 95.11.21 Α BW<sup>-</sup> DATE REV. DESCRIPTION BY

DESIGN	ВW	DART AEROSPACE L	_TD
DRAWN	AJS	HAWKESBURY, ONTARIO, CANA	
CHECKED		DRAWING NO.	REV. E
MFG. APPR.	Ma	D2512 SI	HEET 1 OF
APPROVED	1117	TITLE	SCAL
DE APPR.	1	BASKET LID ASSEMBLY (350/212)	NT
DATE OO C	)C 47	COPYRIGHT @ 1995 BY DART AEROSPACE I	

08.06.17

RE URN TO ENG NEERING

UNCONTROLLED COPY

SUBJECT

